

SUBMIT: COMPLETED APPLICATION, TAX
STATEMENT AND FEE TO:
Bayfield County
Planning and Zoning Depart.
PO Box 58
Washburn, WI 54891
(715) 373-6138

APPLICATION FOR PERMIT
BAYFIELD COUNTY, WISCONSIN

RECEIVED
MAR 20 2017

ENTERED

Permit #:	17-0029
Date:	4-27-17
Amount Paid:	\$150 3-21-17
Refund:	

INSTRUCTIONS: No permits will be issued until all fees are paid.
Checks are made payable to: Bayfield County Zoning Department.
DO NOT START CONSTRUCTION UNTIL ALL PERMITS HAVE BEEN ISSUED TO APPLICANT BY Bayfield Co. Zoning Dept.

TYPE OF PERMIT REQUESTED: <input checked="" type="checkbox"/> LAND USE <input type="checkbox"/> SANITARY <input type="checkbox"/> PRIVY <input type="checkbox"/> CONDITIONAL USE <input type="checkbox"/> SPECIAL USE <input type="checkbox"/> B.O.A. <input type="checkbox"/> OTHER				
Owner's Name:	Mailing Address:	City/State/Zip:	Telephone:	
Thomas D. and Ruth M. Miller	56879 S. GURLE	Menomonie, WI 54751		
Address of Property:	City/State/Zip:		Cell Phone:	
10580 Cedarcrest Dr	Iron River, WI	54847	715-505-1075	
Contractor:	Contractor Phone:	Plumber:	Plumber Phone:	
Loren Wichlund	715-392-3358	John Turca	218-391-0516	
Authorized Agent: (Person Signing Application on behalf of Owner(s))	Agent Phone:	Agent Mailing Address (include City/State/Zip):	Written Authorization Attached <input type="checkbox"/> Yes <input type="checkbox"/> No	
PROJECT LOCATION	Legal Description: (Use Tax Statement)	Tax ID# (4-5 digits)	Recorded Deed (i.e. # assigned by Register of Deeds) Document #: _____ R- _____	
Sub 1/4, SE 1/4	Gov't Lot 8 CSM Vol & Page	Lot(s) No. Block(s) No.	Subdivision:	
Section 03, Township 46 N, Range 08 W	Town of Delta	Lot Size	Acreage 4.08	
Shoreland <input checked="" type="checkbox"/> Non-Shoreland <input type="checkbox"/>	<input type="checkbox"/> Is Property/Land within 300 feet of River, Stream (incl. intermittent) Creek or Landward side of Floodplain? <input checked="" type="checkbox"/> Is Property/Land within 1000 feet of Lake, Pond or Flowage If yes--continue -->	Distance Structure is from Shoreline: _____ feet	Is Property in Floodplain Zone? <input type="checkbox"/> Yes <input checked="" type="checkbox"/> No	Are Wetlands Present? <input type="checkbox"/> Yes <input checked="" type="checkbox"/> No
	Distance Structure is from Shoreline: _____ feet			

Value at Time of Completion * include donated time & material	Project	# of Stories and/or basement	Use	# of bedrooms	What Type of Sewer/Sanitary System Is on the property?	Water
\$50,000	<input type="checkbox"/> New Construction <input checked="" type="checkbox"/> Addition/Alteration <input type="checkbox"/> Conversion <input type="checkbox"/> Relocate (existing bldg) <input type="checkbox"/> Run a Business on Property	<input type="checkbox"/> 1-Story <input checked="" type="checkbox"/> 1-Story + Loft <input type="checkbox"/> 2-Story <input checked="" type="checkbox"/> Basement <input type="checkbox"/> No Basement <input type="checkbox"/> Foundation	<input type="checkbox"/> Seasonal <input checked="" type="checkbox"/> Year Round	<input type="checkbox"/> 1 <input checked="" type="checkbox"/> 2 <input type="checkbox"/> 3	<input type="checkbox"/> Municipal/City <input type="checkbox"/> (New) Sanitary <input checked="" type="checkbox"/> Sanitary (Exists) Specify Type: <u>Re: Septic</u> <input type="checkbox"/> Privy (Pit) or <input type="checkbox"/> Vaulted (min 200 gallon) <input type="checkbox"/> Portable (w/service contract) <input type="checkbox"/> Compost Toilet <input type="checkbox"/> None	<input type="checkbox"/> City <input checked="" type="checkbox"/> Well

Existing Structure: (If permit being applied for is relevant to it)	Length: 48	Width: 24	Height: 12
Proposed Construction:	Length:	Width:	Height:

Proposed Use	Proposed Structure	Dimensions	Square Footage
<input checked="" type="checkbox"/> Residential Use	<input type="checkbox"/> Principal Structure (first structure on property)	() X ()	
	Residence (i.e. cabin, hunting shack, etc.)	() X ()	
	with Loft	() X ()	
	with a Porch	() X ()	
	with (2 nd) Porch	() X ()	
	with a Deck	() X ()	
<input type="checkbox"/> Commercial Use	with Attached Garage	() X ()	
	Bunkhouse w/ <input type="checkbox"/> sanitary, or <input type="checkbox"/> sleeping quarters, or <input type="checkbox"/> cooking & food prep facilities	() X ()	
	Mobile Home (manufactured date)	() X ()	
<input checked="" type="checkbox"/> Municipal Use	Addition/Alteration (specify) <u>Garage w/ Basement & storage</u>	(28 X 32)	896
	Accessory Building (specify) <u>new entry</u>	(8 X 21)	168
	Accessory Building Addition/Alteration (specify)	() X ()	
Paid for (if permitted)	Special Use: (explain)	() X ()	
APR 27 2017	Conditional Use: (explain)	() X ()	
	Other: (explain)	() X ()	

FAILURE TO OBTAIN A PERMIT OR STARTING CONSTRUCTION WITHOUT A PERMIT WILL RESULT IN PENALTIES.

I (we) declare that this application (including any accompanying information) has been examined by me (us) and to the best of my (our) knowledge and belief it is true, correct and complete. I (we) acknowledge that I (we) am (are) responsible for the detail and accuracy of all information I (we) am (are) providing and that it will be relied upon by Bayfield County in determining whether to issue a permit. I (we) further acknowledge that any may be a result of Bayfield County relying on this information (we) am (are) providing in or with this application. I (we) consent to county officials charged with administering county ordinances to have access to the above described property and any reasonable information related to the purchase of inspection.

Owner(s): Thomas D. and Ruth M. Miller Gurle Miller Date 3/17/2017
(If there are Multiple Owners listed on the Deed All Owners must sign or letter(s) of authorization must accompany this application)

Authorized Agent: _____ Date _____
(If you are signing on behalf of the owner(s) a letter of authorization must accompany this application)


Address to send permit 56879 S. GURLE Menomonie, WI 54751 Attach Copy of Tax Statement
Thomas D. Miller If you recently purchased the property send your Recorded Deed

APPLICANT - PLEASE COMPLETE PLOT PLAN ON REVERSE SIDE

Draw or Sketch your Property (regardless of what you are applying for)

- Proposed Construction
- 1) Show Location of: North (N) on Plot Plan
- 2) Show / Indicate: (*) Driveway and (*) Frontage Road (Name Frontage Road)
- 3) Show Location of (*): All Existing Structures on Your Property
- 4) Show: (*) Well (W); (*) Septic Tank (ST); (*) Drain Field (DF); (*) Holding Tank (HT) and/or (*) Privy (P)
- 5) Show: (*) Lake; (*) River; (*) Stream/Creek; or (*) Pond
- 6) Show any (*): (*) Wetlands; or (*) Slopes over 20%
- 7) Show any (*):

Copy of Survey attached
that has driveway + InSettlement

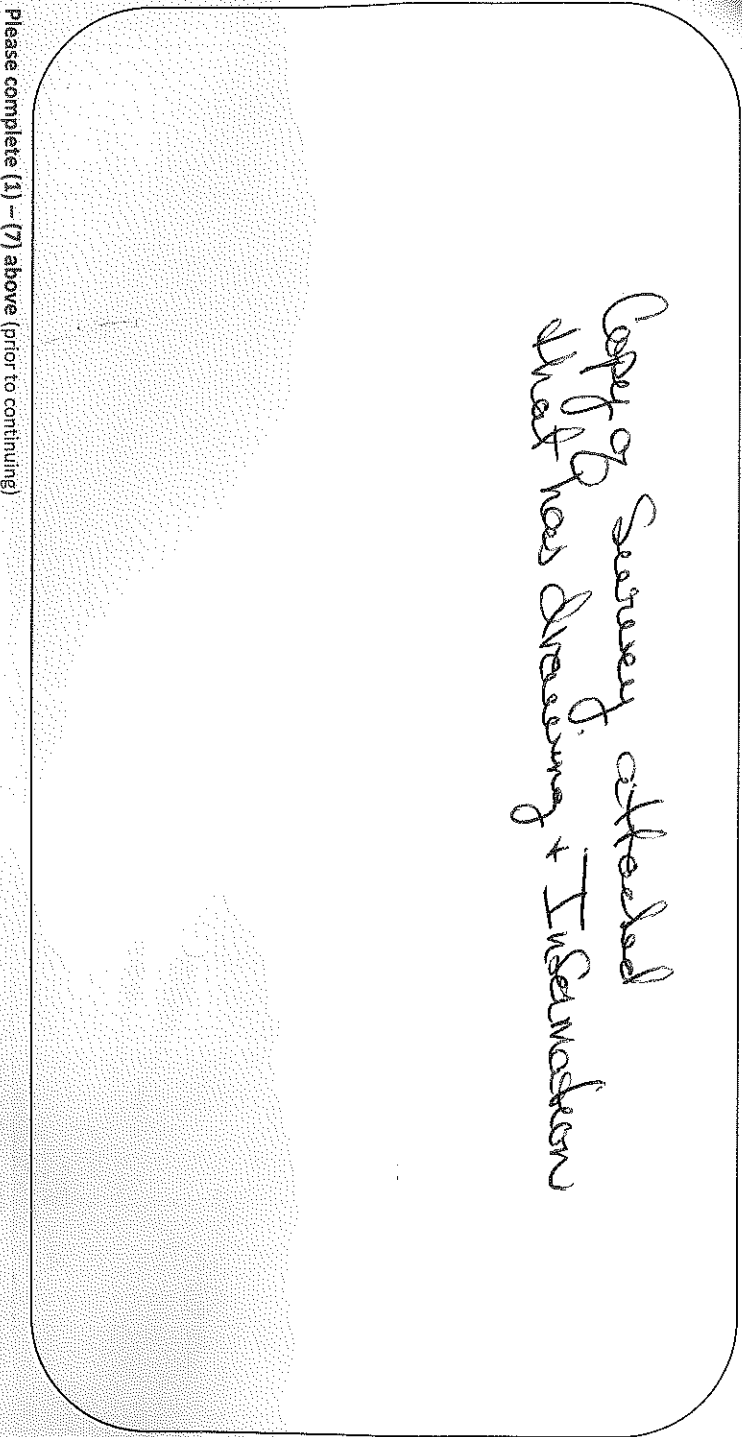

Please complete (1) - (7) above (prior to continuing)

(8) Setbacks: (measured to the closest point)

Changes in plans must be approved by the Planning & Zoning Dept.

Description	Measurement	Description	Measurement
Setback from the Centerline of Platted Road	House / Garage / 500 Feet	Setback from the Lake (ordinary high-water mark)	House / Garage / 107 / 150 Feet
Setback from the Established Right-of-Way	63 / 59 Feet	Setback from the River, Stream, Creek	107 / 150 Feet
Setback from the North Lot Line	107 / 150 Feet	Setback from the Bank or Bluff	107 / 150 Feet
Setback from the South Lot Line	35 / 25 Feet	Setback from Wetland	107 / 150 Feet
Setback from the West Lot Line	30 / 58 Feet	20% Slope Area on property	□ Yes <input checked="" type="checkbox"/> No
Setback from the East Lot Line	15 Feet	Elevation of Floodplain	107 / 150 Feet
Setback to Septic Tank or Holding Tank	10 / 45 Feet	Setback to Well	10 / 30 Feet
Setback to Drain Field	10 / 45 Feet		
Setback to Privy (Portable, Composting)	10 / 45 Feet		

Prior to the placement or construction of a structure within ten (10) feet of the minimum required setback, the boundary line from which the setback must be measured must be visible from one previously surveyed corner to the other previously surveyed corner or marked by a licensed surveyor at the owner's expense.

Prior to the placement or construction of a structure more than ten (10) feet but less than thirty (30) feet from the minimum required setback, the boundary line from which the setback must be measured must be visible from one previously surveyed corner to the other previously surveyed corner, or verifiable by the Department by use of a corrected compass from a known corner within 500 feet of the proposed site of the structure, or must be marked by a licensed surveyor at the owner's expense.

(9) Stake or Mark Proposed Location(s) of New Construction, Septic Tank (ST), Drain Field (DF), Holding Tank (HT), Privy (P), and Well (W).

NOTICE: All Land Use Permits Expire One (1) Year from the Date of Issuance if Construction or Use has not begun.

For The Construction Of New One & Two Family Dwellings: ALL Municipalities Are Required To Enforce The Uniform Dwelling Code.

The local Town, Village, City, State or Federal agencies may also require permits.

Issuance Information (County Use Only)		Sanitary Number: 297808	# of bedrooms: 2	Sanitary Date: 10-8-98			
Permit Denied (Date):		Reason for Denial:					
Permit #: 17-0079		Permit Date: 4-27-17					
Is Parcel a Sub-Standard Lot	<input type="checkbox"/> Yes <input checked="" type="checkbox"/> No	(Deed of Record)	<input type="checkbox"/> Yes <input checked="" type="checkbox"/> No	Mitigation Required	<input type="checkbox"/> Yes <input checked="" type="checkbox"/> No	Affidavit Required	<input type="checkbox"/> Yes <input checked="" type="checkbox"/> No
Is Parcel in Common Ownership	<input type="checkbox"/> Yes <input checked="" type="checkbox"/> No	(Fused/Contiguous Lot(s))	<input checked="" type="checkbox"/> No	Mitigation Attached	<input type="checkbox"/> Yes <input checked="" type="checkbox"/> No	Affidavit Attached	<input type="checkbox"/> Yes <input checked="" type="checkbox"/> No
Is Structure Non-Conforming	<input type="checkbox"/> Yes <input checked="" type="checkbox"/> No						
Granted by Variance (B.O.A.)		Case #:	Previously Granted by Variance (B.O.A.)		Case #:		
<input type="checkbox"/> Yes <input checked="" type="checkbox"/> No			<input type="checkbox"/> Yes <input checked="" type="checkbox"/> No				
Was Parcel Legally Created		<input checked="" type="checkbox"/> Yes <input type="checkbox"/> No	Were Property Lines Represented by Owner		<input checked="" type="checkbox"/> Yes <input type="checkbox"/> No		
Was Proposed Building Site Delineated		<input checked="" type="checkbox"/> Yes <input type="checkbox"/> No	Was Property Surveyed		<input checked="" type="checkbox"/> Yes <input type="checkbox"/> No		
Inspection Record:							
Date of Inspection: 9-21-17		Inspected by: L.A. 98-616		Zoning District (RCS)		Date of Re-Inspection:	
		Luis Stangas - 2 bedroom		Lakes Classification (/)			
Condition(s): Town, Committee or Board Conditions Attached? Yes <input type="checkbox"/> No <input checked="" type="checkbox"/> (If No they need to be attached.)							
Must Mark: 63' from center of Road.							
Must get UDC If Required or.							
Signature of Inspector: Joe Dooly							
Hold For Sanitary: <input type="checkbox"/>		Hold For TBA: <input type="checkbox"/>		Hold For Affidavit: <input type="checkbox"/>		Hold For Fees: <input type="checkbox"/>	
						Date of Approval: 4-27-17	

EA
FEET±
±


1
2
SEPTIC VENTS

Drain Field

8

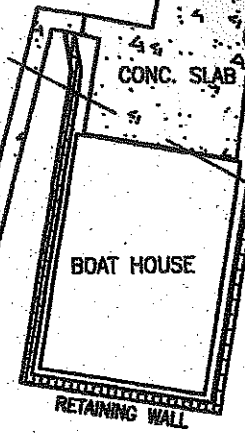


(RECORDED AS N 12°38'40" E, 159.09')
N 11°34'08" E
160.22'

WOODEN FENCE



X Well

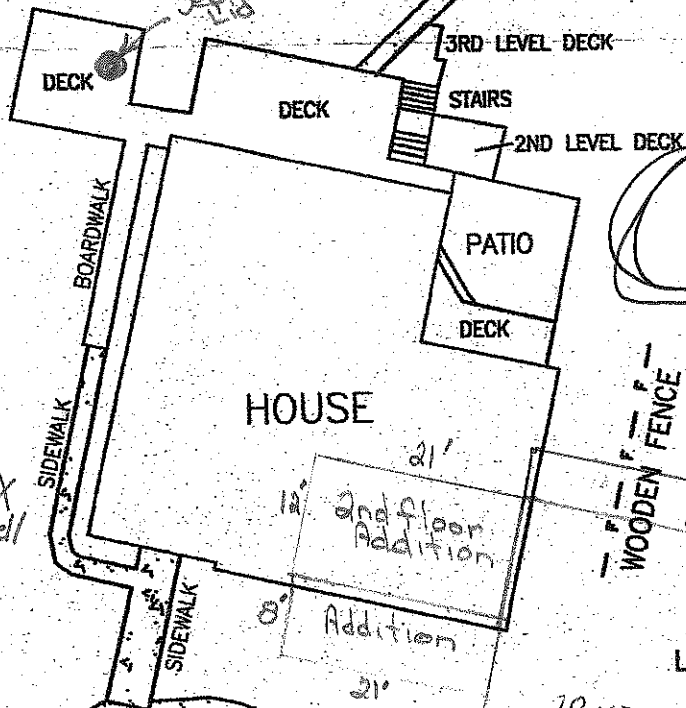


1" = 20'

WOODEN FENCE

LP TANK

28x32 Garage

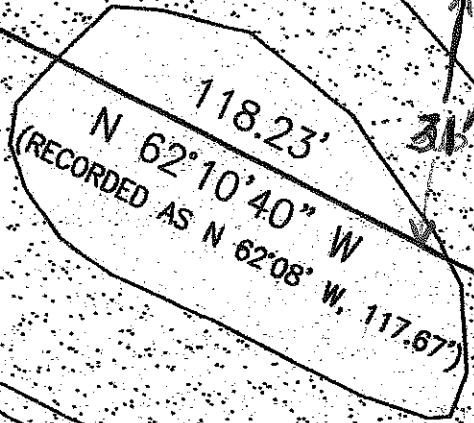

118.23'
(RECORDED AS N 62°10'40" W
N 62°08' W, 117.67')

TAN = S 59°31'26" E C7

CedarCrest Drive

S 03°30'22" W
(RECORDED AS N 04°38'20" E, 166.75')

PLATTED C/L CEDAR
(RECORDED AS 65.29')

65.29'
20.00'

SUBMIT COMPLETED APPLICATION, TAX STATEMENT AND FEE TO:
Bayfield County
Planning and Zoning Depart.
PO Box 58
Washburn, WI 54891
(715) 373-6138

APPLICATION FOR PERMIT
BAYFIELD COUNTY, WISCONSIN
Date Stamp Received
APR 20 2017
Bayfield Co. Zoning Dept.

ENTERED

Permit #:	17-0087
Date:	4-28-17
Amount Paid:	\$90 420-17
Refund:	\$100 420-17

INSTRUCTIONS: No permits will be issued until all fees are paid.
Checks are made payable to: Bayfield County Zoning Department.
DO NOT START CONSTRUCTION UNTIL ALL PERMITS HAVE BEEN ISSUED TO APPLICANT.

TYPE OF PERMIT REQUESTED → <input checked="" type="checkbox"/> LAND USE <input type="checkbox"/> SANITARY <input type="checkbox"/> PRIVY <input type="checkbox"/> CONDITIONAL USE <input type="checkbox"/> SPECIAL USE <input type="checkbox"/> B.O.A. <input type="checkbox"/> OTHER			
Owner's Name: <u>Laurel Davis</u>	Mailing Address: <u>43630 Ledin Rd</u>	City/State/Zip: <u>WI 54847</u>	Telephone: <u>373-8837</u>
Address of Property: <u>Ledin Road</u>	Contractor Phone: <u>715-685-1009</u>	Plumber: <u>715-292-387</u>	Cell Phone: <u>619-928-4001</u>
Contractor: <u>SCP Construction</u>	Authorized Agent: (Person Signing Application on behalf of Owner(s)) <u>Steven C. Petek</u>	Agent Phone: <u>715-292-387</u>	Plumber Phone: <u>715-292-387</u>
Project Location: <u>SW 1/4, NW 1/4</u>	Legal Description: (Use Tax Statement) <u>SW 1/4, NW 1/4</u>	Tax ID # (4-5 digits) <u>13277</u>	Written Authorization Attached <input checked="" type="checkbox"/> Yes <input type="checkbox"/> No
Section <u>3</u> , Township <u>46</u> N, Range <u>8</u> W	Town of: <u>Delta</u>	Block(s) No. <u>206R506664</u>	Recorded Deed (i.e. # assigned by Register of Deeds) <u>206R506664</u>
Distance Structure is from Shoreline: feet	Distance Structure is from Floodplain: feet	Is Property in Floodplain Zone? <input type="checkbox"/> Yes <input checked="" type="checkbox"/> No	Are Wetlands Present? <input type="checkbox"/> Yes <input checked="" type="checkbox"/> No

Value at Time of Completion * include donated time & material <u>\$30,000</u>	Project and/or basement	Use	# of bedrooms	What Type of Sewer/Sanitary System is on the property?		Water
				Is Property/Land within 300 feet of River, Stream (incl. intermittent) Creek or Landward side of Floodplain? <input type="checkbox"/> Is Property/Land within 1000 feet of Lake, Pond or Flowage If Yes---continue →		
				Distance Structure is from Shoreline: feet		
				Distance Structure is from Floodplain: feet		
				Is Property in Floodplain Zone? <input type="checkbox"/> Yes <input checked="" type="checkbox"/> No		
<input checked="" type="checkbox"/> Non-Shoreland	<input checked="" type="checkbox"/> New Construction	<input checked="" type="checkbox"/> 1-Story	<input type="checkbox"/> Seasonal	<input type="checkbox"/> 1	<input type="checkbox"/> Municipal/City	<input type="checkbox"/> City
	<input type="checkbox"/> Addition/Alteration	<input type="checkbox"/> 1-Story + Loft	<input checked="" type="checkbox"/> Year Round	<input type="checkbox"/> 2	<input type="checkbox"/> (New) Sanitary Specify Type: <u>3.0 ft x 1.4 ft</u>	<input checked="" type="checkbox"/> Well
	<input type="checkbox"/> Conversion	<input type="checkbox"/> 2-Story	<input type="checkbox"/> Basement	<input type="checkbox"/> 3	<input type="checkbox"/> Sanitary (exists) Specify Type: <u>3.0 ft x 1.4 ft</u>	<input type="checkbox"/>
	<input type="checkbox"/> Relocate (existing bldg)	<input type="checkbox"/> No Basement	<input checked="" type="checkbox"/> Foundation	<input type="checkbox"/> None	<input type="checkbox"/> Privy (Pit) or <input type="checkbox"/> Vaulted (min 200 gallon)	<input type="checkbox"/>
	<input type="checkbox"/> Run a Business on Property	<input type="checkbox"/> Foundation	<input type="checkbox"/> None	<input type="checkbox"/> Compost Toilet	<input type="checkbox"/> None	<input type="checkbox"/>

Existing Structure: (if permit being applied for is relevant to it)	Length: <u>24'</u>	Width: <u>30'</u>	Height: <u>13'</u>
Proposed Construction:	Length: <u>24'</u>	Width: <u>30'</u>	Height: <u>13'</u>

Proposed Use	✓	Proposed Structure	Dimensions	Square Footage
<input checked="" type="checkbox"/> Residential Use	<input type="checkbox"/>	Residence (i.e. cabin, hunting shack, etc.)	(<input checked="" type="checkbox"/>)	
	<input type="checkbox"/>	with Loft	(<input checked="" type="checkbox"/>)	
	<input type="checkbox"/>	with a Porch	(<input checked="" type="checkbox"/>)	
	<input type="checkbox"/>	with (2 nd) Porch	(<input checked="" type="checkbox"/>)	
	<input type="checkbox"/>	with a Deck	(<input checked="" type="checkbox"/>)	
	<input type="checkbox"/>	with (2 nd) Deck	(<input checked="" type="checkbox"/>)	
	<input type="checkbox"/>	with Attached Garage	(<input checked="" type="checkbox"/>)	
	<input type="checkbox"/>	Bunkhouse w/ (<input type="checkbox"/> sanitary, or <input type="checkbox"/> sleeping quarters, or <input type="checkbox"/> cooking & food prep facilities)	(<input checked="" type="checkbox"/>)	
	<input type="checkbox"/>	Mobile Home (manufactured date)	(<input checked="" type="checkbox"/>)	
	<input type="checkbox"/>	Addition/Alteration (specify)	(<input checked="" type="checkbox"/>)	
<input type="checkbox"/> Commercial Use	<input checked="" type="checkbox"/>	Accessory Building (specify) <u>garage - 2 car</u>	(<input checked="" type="checkbox"/>)	<u>24x30</u>
	<input type="checkbox"/>	Accessory Building Addition/Alteration (specify)	(<input checked="" type="checkbox"/>)	
	<input type="checkbox"/>	Other: (explain)	(<input checked="" type="checkbox"/>)	
<input type="checkbox"/> Municipal Use	<input type="checkbox"/>	Special Use: (explain)	(<input checked="" type="checkbox"/>)	
	<input type="checkbox"/>	Conditional Use: (explain)	(<input checked="" type="checkbox"/>)	
	<input type="checkbox"/>	Other: (explain)	(<input checked="" type="checkbox"/>)	
Rec'd for Issuance				
APR 28 2017				

Secretarial Staff

FAILURE TO OBTAIN A PERMIT OR STARTING CONSTRUCTION WITHOUT A PERMIT WILL RESULT IN PENALTIES.
I (we) declare that this application (including any accompanying information) has been examined by me (us) and to the best of my (our) knowledge and belief it is true, correct and complete. I (we) acknowledge that I (we) am (are) responsible for the detail and accuracy of all information I (we) am (are) providing and that it will be relied upon by Bayfield County in determining whether to issue a permit. I (we) further accept liability which may be a result of Bayfield County relying on this information. I (we) am (are) providing in or with this application. I (we) consent to county officials charged with administering county ordinances to have access to the above described property at any reasonable time for the purpose of inspection.

Owner(s): Laurel Davis Date 4/20/17

Authorized Agent: Steven C. Petek (If you are signing on behalf of the owner(s) a letter of authorization must accompany this application) Date 4/20/17

Address to send permit Bayfield Co. Zoning Dept. Attach Copy of Tax Statement If you recently purchased the property send your Recorded Deed

Draw or Sketch your Property (regardless of what you are applying for)

- (1) Show Location of: **Proposed Construction**
(2) Show / Indicate: **North (N) on Plot Plan**
(3) Show Location of (*): **(*) Driveway and (*) Frontage Road (Name Frontage Road)**
(4) Show: **All Existing Structures on Your Property**
(5) Show: **(*) Well (W); (*) Septic Tank (ST); (*) Drain Field (DF); (*) Holding Tank (HT) and/or (*) Privy (P)**
(6) Show any (*): **(*) Lake; (*) River; (*) Stream/Creek; or (*) Pond**
(7) Show any (*): **(*) Wetlands; or (*) Slopes over 20%**

See attached

Please complete (1) – (7) above (prior to continuing)

(8) Setbacks: (measured to the closest point)

Changes in plans must be approved by the Planning & Zoning Dept.

Description	Measurement	Description	Measurement
Setback from the Centerline of Platted Road 200	300' Feet	Setback from the Lake (ordinary high-water mark) 145	400' Feet
Setback from the Established Right-of-Way 167	Feet	Setback from the River, Stream, Creek	NA Feet
Setback from the North Lot Line 1412	500' Feet	Setback from the Bank or Bluff	NA Feet
Setback from the South Lot Line 114	150' Feet	Setback from Wetland	300' Feet
Setback from the West Lot Line 306	150' Feet	20% Slope Area on property	<input type="checkbox"/> Yes <input checked="" type="checkbox"/> No
Setback from the East Lot Line LACT	600' Feet	Elevation of Floodplain	Feet
Setback to Septic Tank or Holding Tank	60' Feet	Setback to Well	25' Feet
Setback to Drain Field	Feet		
Setback to Privy (Portable, Composting)	Feet		

Prior to the placement or construction of a structure within ten (10) feet of the minimum required setback, the boundary line from which the setback must be measured must be visible from one previously surveyed corner to the other previously surveyed corner or marked by a licensed surveyor at the owner's expense.

Prior to the placement or construction of a structure more than ten (10) feet but less than thirty (30) feet from the minimum required setback, the boundary line from which the setback must be measured must be visible from one previously surveyed corner to the other previously surveyed corner, or verifiable by the Department by use of a corrected compass from a known corner within 500 feet of the proposed site of the structure, or must be marked by a licensed surveyor at the owner's expense.

(9) Stake or Mark Proposed Location(s) of New Construction, Septic Tank (ST), Drain field (DF), Holding Tank (HT), Privy (P), and Well (W).

NOTICE: All Land Use Permits Expire One (1) Year from the Date of Issuance if Construction or Use has not begun.


For The Construction Of New One & Two Family Dwellings: ALL Municipalities Are Required To Enforce The Uniform Dwelling Code.

The local Town, Village, City, State or Federal agencies may also require permits.

Issuance Information (County Use Only)		Sanitary Number:	# of bedrooms:	Sanitary Date:		
Permit Denied (Date):		Reason for Denial:				
Permit #: 17-0087		Permit Date: 4-28-17				
Is Parcel a Sub-Standard Lot	<input type="checkbox"/> Yes (Deed of Record)	<input checked="" type="checkbox"/> No	Mitigation Required	<input type="checkbox"/> Yes <input checked="" type="checkbox"/> No	Affidavit Required	<input type="checkbox"/> Yes <input checked="" type="checkbox"/> No
Is Parcel in Common Ownership	<input type="checkbox"/> Yes (Fused/Contiguous Lot(s))	<input checked="" type="checkbox"/> No	Mitigation Attached	<input type="checkbox"/> Yes <input checked="" type="checkbox"/> No	Affidavit Attached	<input type="checkbox"/> Yes <input checked="" type="checkbox"/> No
Is Structure Non-Conforming	<input type="checkbox"/> Yes	<input checked="" type="checkbox"/> No				
Granted by Variance (B.O.A.)		Previously Granted by Variance (B.O.A.)				
<input type="checkbox"/> Yes <input checked="" type="checkbox"/> No	Case #:	<input type="checkbox"/> Yes <input checked="" type="checkbox"/> No	Case #:			
Was Parcel Legally Created	<input type="checkbox"/> Yes <input checked="" type="checkbox"/> No	Were Property Lines Represented by Owner	<input type="checkbox"/> Yes <input checked="" type="checkbox"/> No			
Was Proposed Building Site Delineated	<input type="checkbox"/> Yes <input checked="" type="checkbox"/> No	Was Property Surveyed	<input type="checkbox"/> Yes <input checked="" type="checkbox"/> No			
Inspection Record: Project Well Staked (See Photos). Location as represented appears to identify Code Compliant location. OK to issue LV permit		Zoning District (ARB)				
Date of Inspection: 4/27/2017		Inspected by: Robert Schickman		Lakes Classification ()		
Conditions: Town, Committee or Board Conditions Attached? <input type="checkbox"/> Yes <input checked="" type="checkbox"/> No - (if No they need to be attached.)		Date of Re-Inspection:				
Not to be used for Human habitation.						
Signature of Inspector: [Signature]		Date of Approval: 4/27/17				
Hold For Sanitary: <input type="checkbox"/>	Hold For TBA: <input type="checkbox"/>	Hold For Affidavit: <input type="checkbox"/>	Hold For Fees: <input type="checkbox"/>			

(1) Show
(2) Show
(3) Show
(4) Show
(5) Show
(9) Show
(2) Show

Bayfield County Web AppBuilder

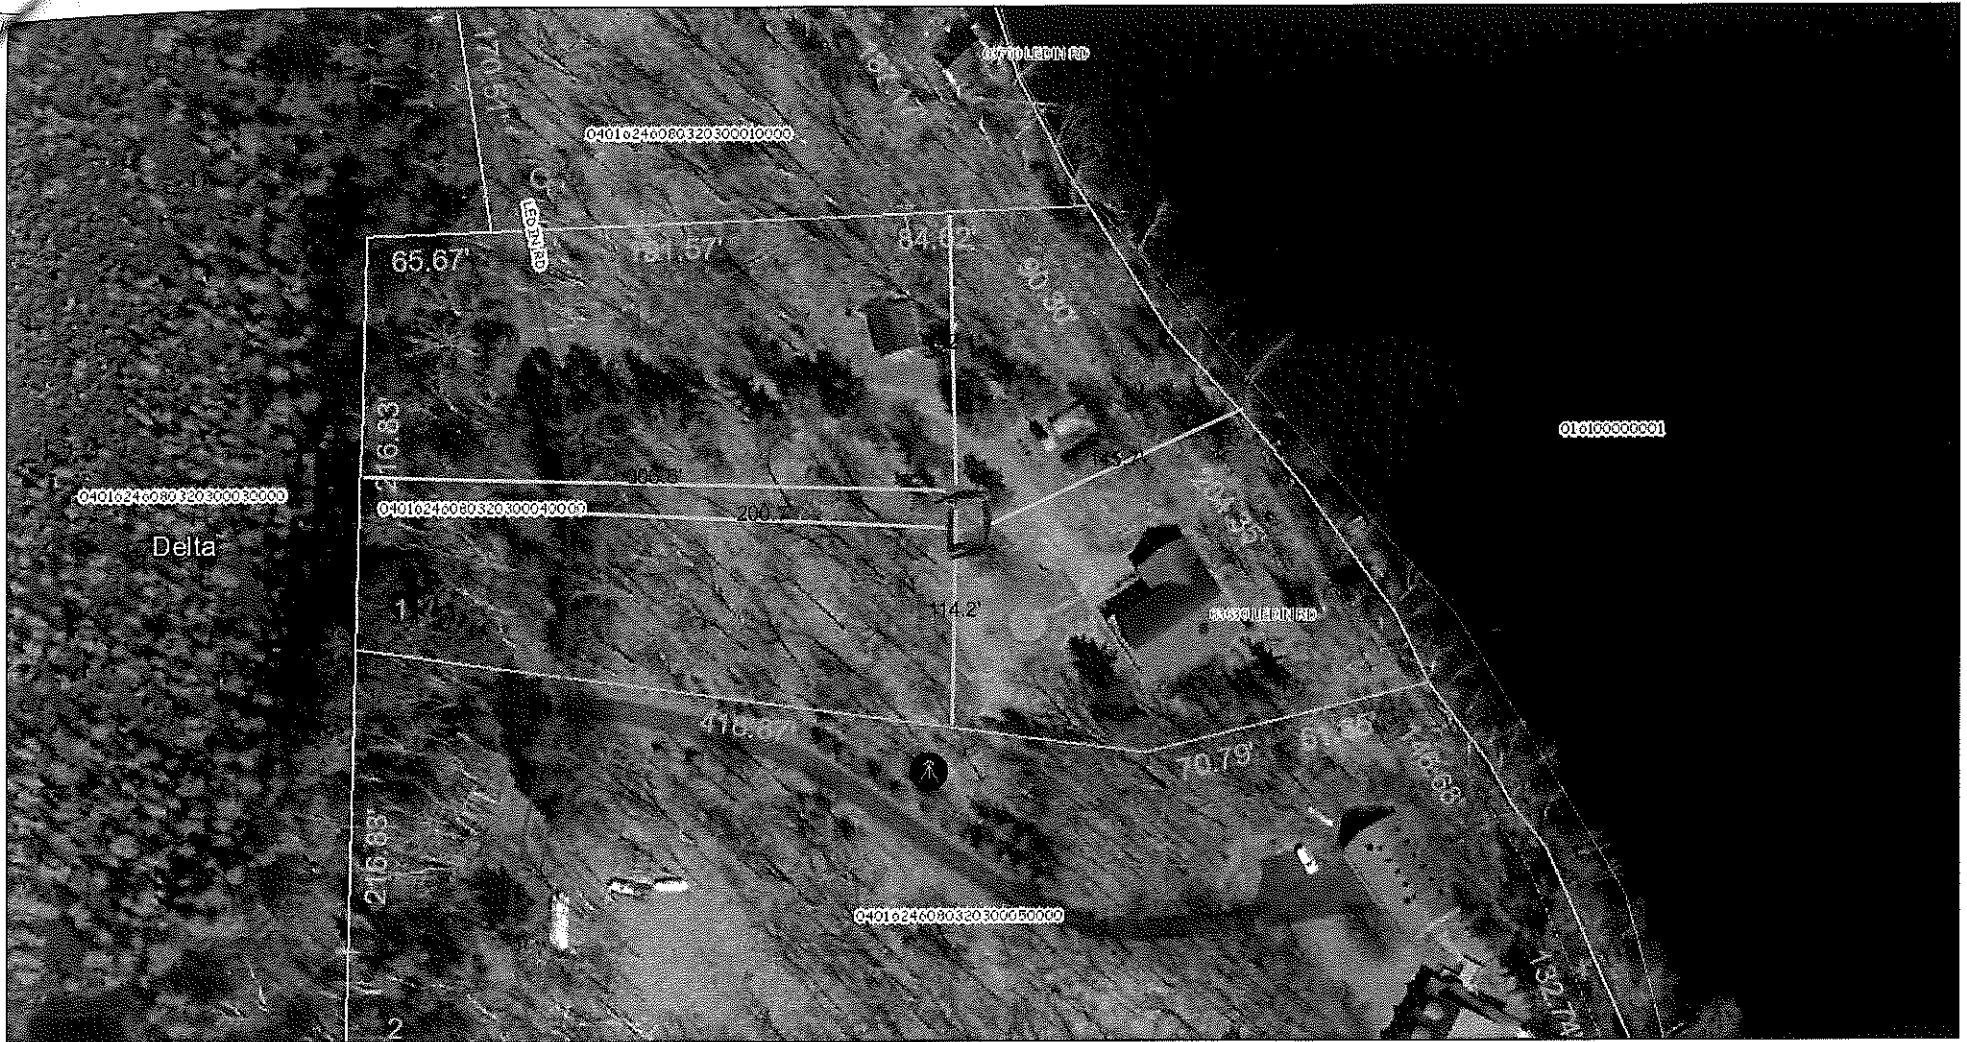

April 26, 2017

Building

Corner Tie Sheets

Section Corner Monument on File
Section Corner Monument Referenced on Survey

Survey Maps

UnRecorded Map

Recorded Map

Road Type

CFR
County
Federal
Private

State

Town

Municipal Boundary

Section Lines

Approximate Parcel Boundary

Meander Line


Tie Line

Rivers

Douglas Co Parcels

Ashland Co Parcel

1:783

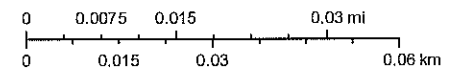

Bayfield County
Bayfield